

**REQUEST FOR PROPOSALS**  
**(COMPETITIVE SEALED PROPOSALS)**

**Hospital Reheat Hot Water System  
Upgrade**

RFP No:  
HHSC 21-0044  
**ADDENDUM #1**  
(Revised/new items are highlighted)

for

Hawaii Health Systems Corporation  
West Hawaii Region  
Kona Community Hospital

Yvonne S. Taylor, Contracts  
Kona Community Hospital  
79-1019 Haukapila Street  
Kealahou, HI 96750  
Telephone (808) 322-9311  
Fax (808) 322-4488  
<http://www.kch.hhsc.org/Procurement/default.aspx>  
An Agency of the State of Hawaii

1. **Questions and Answers**


Q1: Please provide specifications (make and model number) for the new compression tank and the new air separator. Refer to sheet M-106.

A1: Air separator and compression tank are specified in the specs. 15700-6 par 2.05 & 2.06

Q2: Do you have an as built plan for the hot water system on the roof?

A2: The best that is available is the demolition drawing on page M-106.

Q3: Could you please provide pipe sizing at each Reheat Hot Water Boiler? Refer to sheet M-301

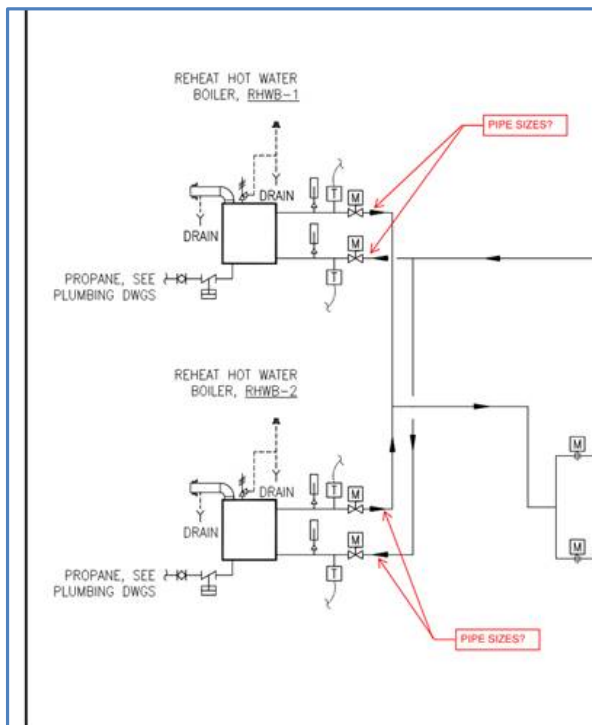

A3: Pipe size at Reheat Boilers 1 & 2 is 2"

Q5: Could you please provide a pipe size for the existing RHWR piping shown below? Please refer to Detail B on sheet M-101.

A5: Pipe size for the existing RHWR piping at ground floor is 1 ¼". Contractor to verify in field.

1. Timetable

No.	Activity	Planned Date
1.	RFP Public Announcement	October 8, 2020
1A	Pre-Proposal Conference at Kona Community Hospital Tour of Hospital Facilities. Reservation form (Appendix G) and signed Confidentiality Agreement (Appendix H) must be received no later than Friday, Oct 16, 2020 <b>This meeting is MANDATORY for all Offerors.</b> See Appendix F for Agenda.	Tuesday October 20, 2020 8:30am – 10:00am HST
2.	Closing Date for Receipt of Questions	Friday, October 23, 2020 2:00pm HST
3.	Addendum #1 for HHSC Response to OFFEROR's Questions	Mon, November 16, 2020
4	Addendum #2 for additional project information	Wed, December 9, 2020
<b>4.</b>	<b>Closing Date for Receipt of Proposals</b>	<b>Wed, December 23, 2020 2:00pm HST</b>
5.	Mandatory Requirements Evaluation	December 29, 2020
6.	Proposal Evaluations	December 31, 2020
7.	Proposal Discussions (optional)	
8.	Best and Final Offers (optional)	
9.	Contractor Selection/Award Notification (on/about)	January 5, 2021
10.	Contract Execution Period	January 6-13, 2021
11.	Contract Tentative Award Date	January 13, 2021